REVISIONS						
ZONE	LTR	DESCRIPTION	ECR	DATE	BY	APRV
	A	REVISED PER APPROVED AURA PRINT REDRAWN		11/12/99		
	B	CORRECTED PICTORIALLY-DELETED DOWEL LOCATING DIMS- AS BUILT		05/02/00		LDS
BD	C	ADDED REF TO 2150.2020001	3342	05/02/00	JED	HE
	D	ADDED REF 215.0007312 PER ECR	3412	05/02/00		AA
	E	REVISED & REDRAWN	3513	05/02/00	J.H.	

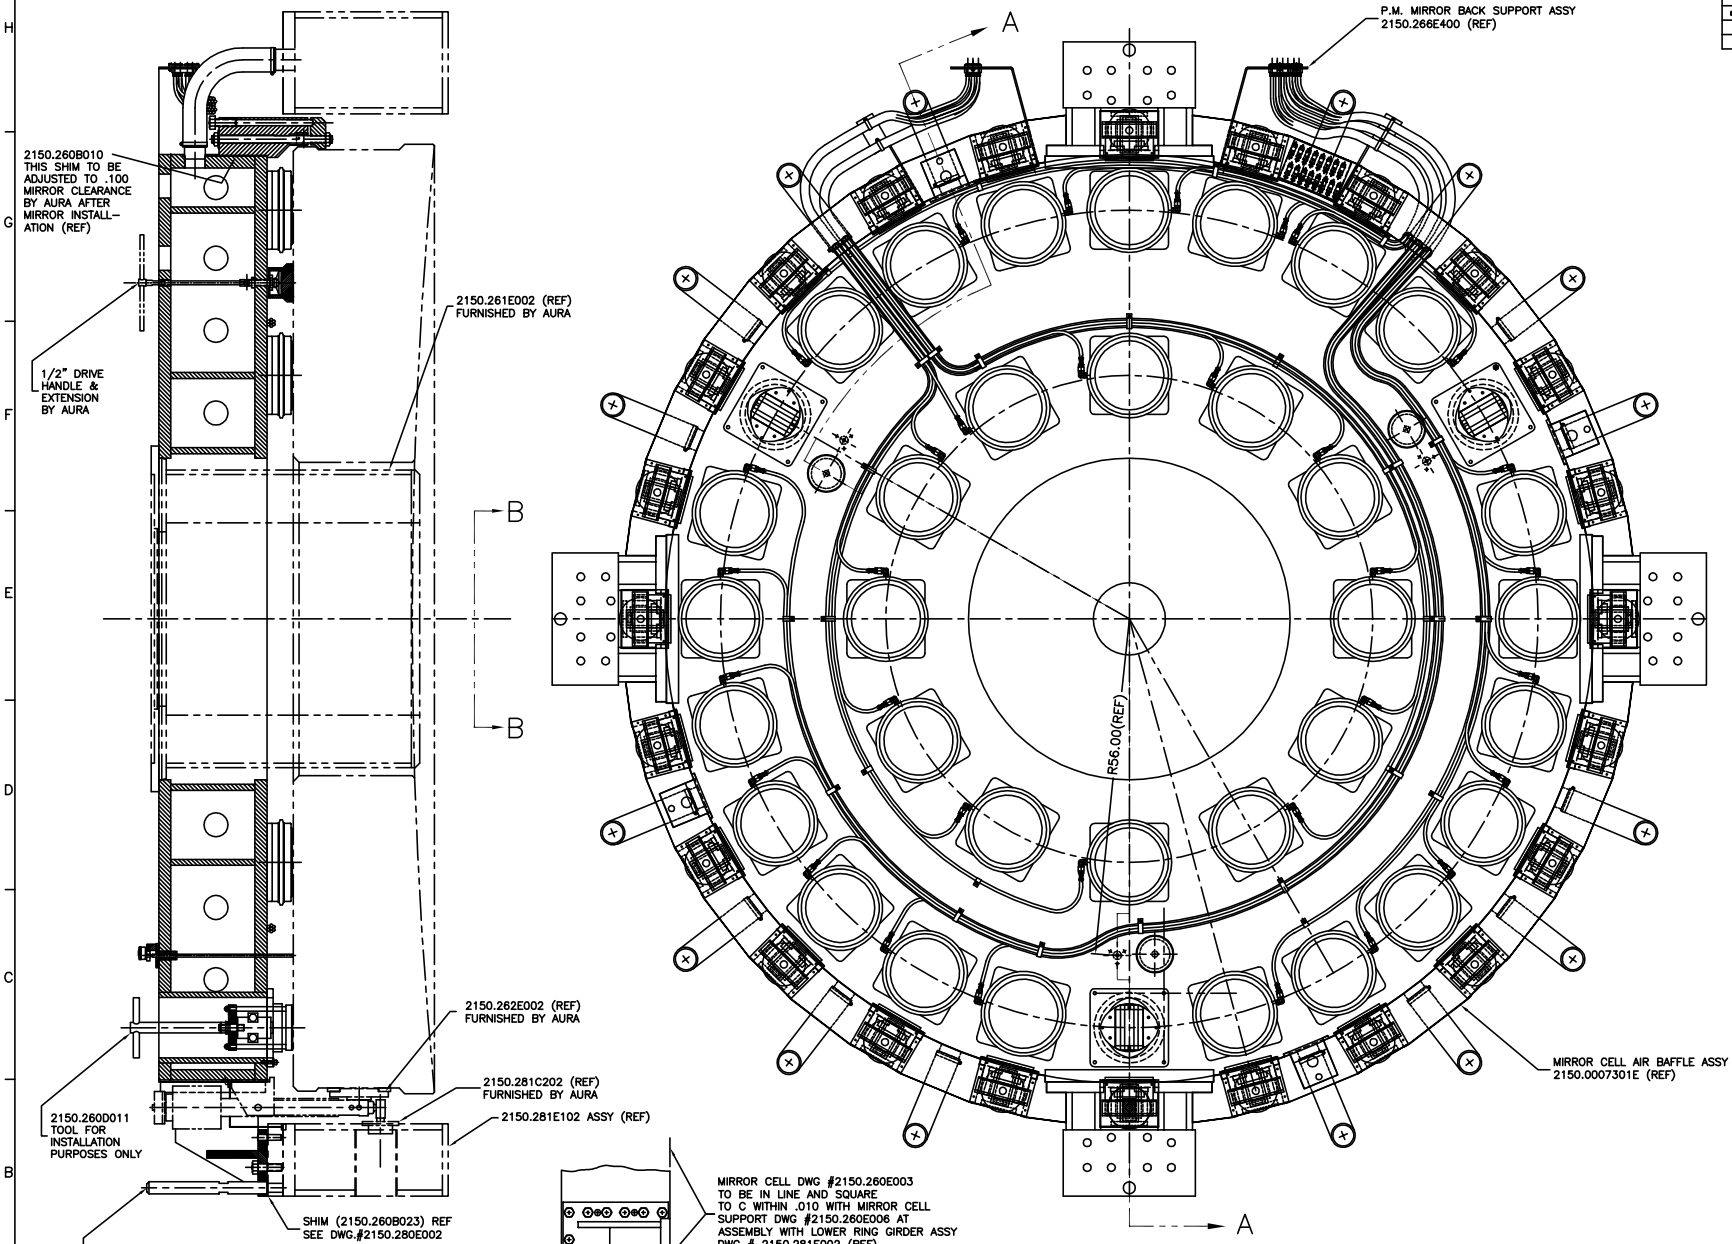

SEE LIST OF MATERIAL

TOLERANCES UNLESS OTHERWISE NOTED
DECIMALS .XX ± .03 .XXX ± .010 FRACTIONS ± 1/32 ANGULAR ± 1°0'

NATIONAL OPTICAL ASTRONOMY OBSERVATORIES
OPERATED BY THE
ASSOCIATION OF UNIVERSITIES FOR RESEARCH IN ASTRONOMY
UNDER COOPERATIVE AGREEMENT WITH
NATIONAL SCIENCE FOUNDATION

NEXT ASSEMBLY: 2150.280E001 (WGN 102803)

NAME: OUTLINE PRIMARY MIRROR CELL

REF FILE: 1171

USED ON

SCALE: 1/8 | DESIGNED BY | DATE | APPROVED BY | DATE | DWG NO: 2150.260E001 | REV: E

DRAWING SOFTWARE VERSION: AUTOCAD v.14 | DRAWN BY: J.Johnson 6/6/69 | CHECKED BY | DATE | APPROVED BY: G.Ruebsch 11/18/69 | DATE | RELEASED | SHEET 1 OF 1