BILL OF MATERIAL

ITEM	QTY.	MATERIAL	DESCRIPTION	WEIGHT

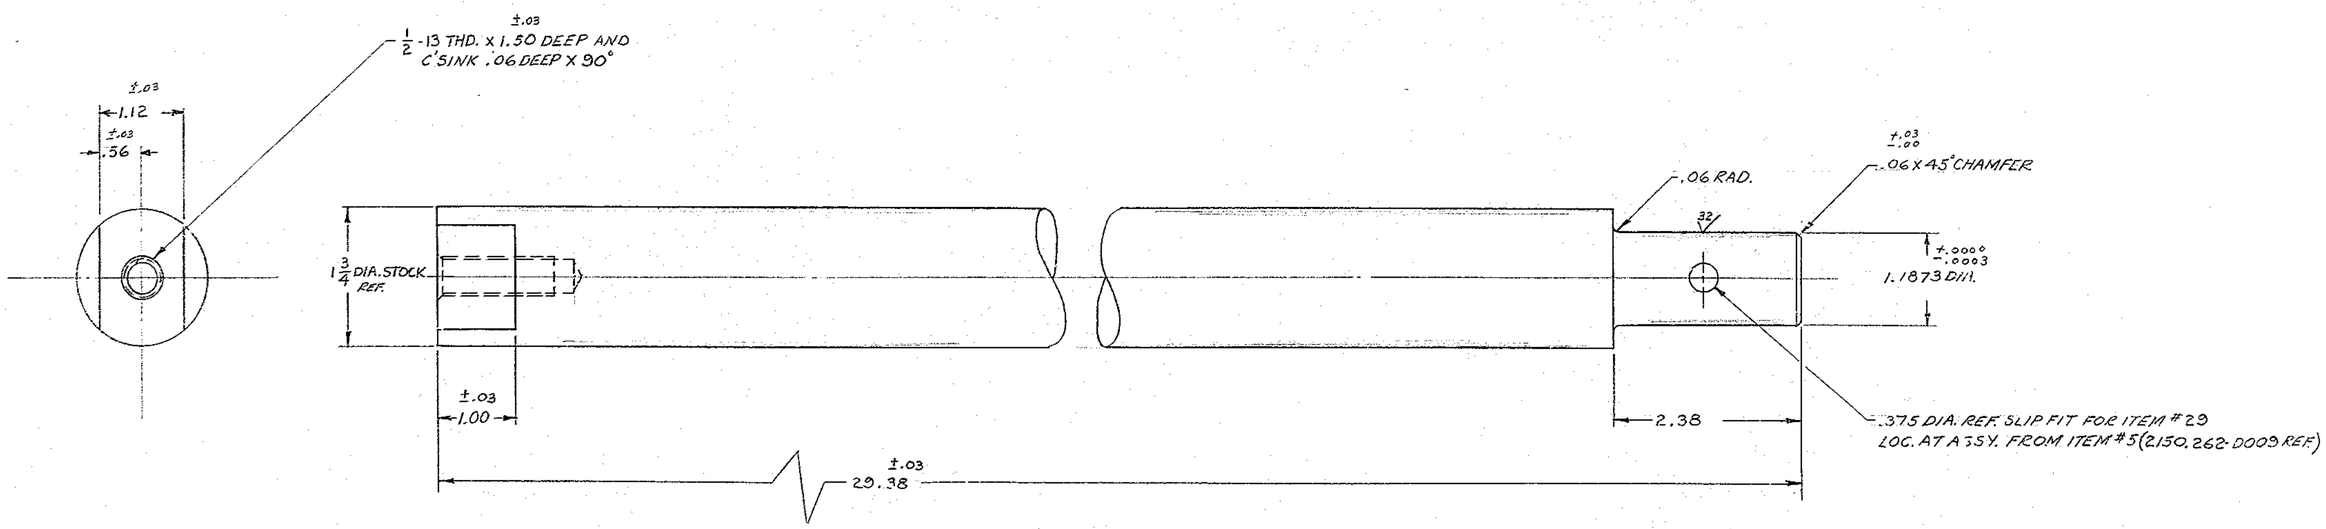

MATERIAL: 1 3/4 DIA. TURNED AND GROUND C1020 STEEL SHAFTING.

FINISH: BLACK OXIDE

ITEM #4

FOR ASSEMBLY SEE 2150.262-E002

LET.	REVISION	ECR	DATE	BY
A	REVISED AS BUILT	0529	7-17-70	L.E. D.L.J.

TOLERANCES UNLESS OTHERWISE NOTED

DECIMAL DIMENSIONS
00.00 ± .010
00.000 ± .003

FRACTIONAL DIMENSIONS
UP TO 18" ± 1/64
18" TO 50" ± 1/32
50" & OVER ± 1/16

BREAK SHARP EDGES .02

ALL SURFACES TO HAVE 125 √ FINISH UNLESS OTHERWISE NOTED.

KITT PEAK NATIONAL OBSERVATORY
OPERATED BY THE
ASSOCIATION OF UNIVERSITIES FOR RESEARCH IN ASTRONOMY, INC.
UNDER CONTRACT WITH
NATIONAL SCIENCE FOUNDATION

150 IN. STELLAR TELESCOPE — REF. FILE 1173

NAME: COUNTER WEIGHT LEVER — SCALE: FULL

PRIMARY MIRROR EDGE SUPPORT — PRINT ISSUED

DESIGNED BY	DATE	APPROVED BY	DATE
[illegible]	10-13-69	[illegible]	10-23-69
DRAWN BY	DATE	APPROVED BY	DATE
[illegible]	10-13-69	[illegible]	11/7/69
CHECKED BY	DATE	APPROVED BY	DATE
[illegible]	11-17-69	[illegible]	10-19-69

DRAWING NUMBER: 2150.262-D008 — REV. A

4/69 DIETERICH-POST CLEARPRINT 1020