"THIS TECHNICAL DATA, FURNISHED UNDER UNITED STATES GOVERNMENT CONTRACT NO. ____ SHALL NOT BE EITHER RELEASED OUTSIDE THE GOVERNMENT, OR USED, DUPLICATED, OR DISCLOSED IN WHOLE OR IN PART FOR MANUFACTURE OR PROCUREMENT, WITHOUT THE WRITTEN PERMISSION OF WESTERN GEAR CORPORATION EXCEPT FOR ITS EMERGENCY REPAIR OR OVERHAUL WORK BY OR FOR THE GOVERNMENT WHERE THE ITEM OR PROCESS CONCERNED IS NOT OTHERWISE REASONABLY AVAILABLE TO ENABLE TIMELY PERFORMANCE OF THE WORK OR (2) RELEASE TO A FOREIGN GOVERNMENT AS THE INTERESTS OF THE UNITED STATES MAY REQUIRE, PROVIDED THAT IN EITHER CASE THE RELEASE, USE, DUPLICATION OR DISCLOSURE HEREOF SHALL BE SUBJECT TO THE FOREGOING LIMITATIONS. THIS LEGEND SHALL BE MARKED ON ANY REPRODUCTION HEREOF IN WHOLE OR IN PART."

REVISIONS

ZONE	LTR	DESCRIPTION	DATE	APPROVED
	K	SEE SECT L-L	2-5-75	?
	L	REVISED PER DRAWN FOR AS BUILT	7-8-75	V.R.

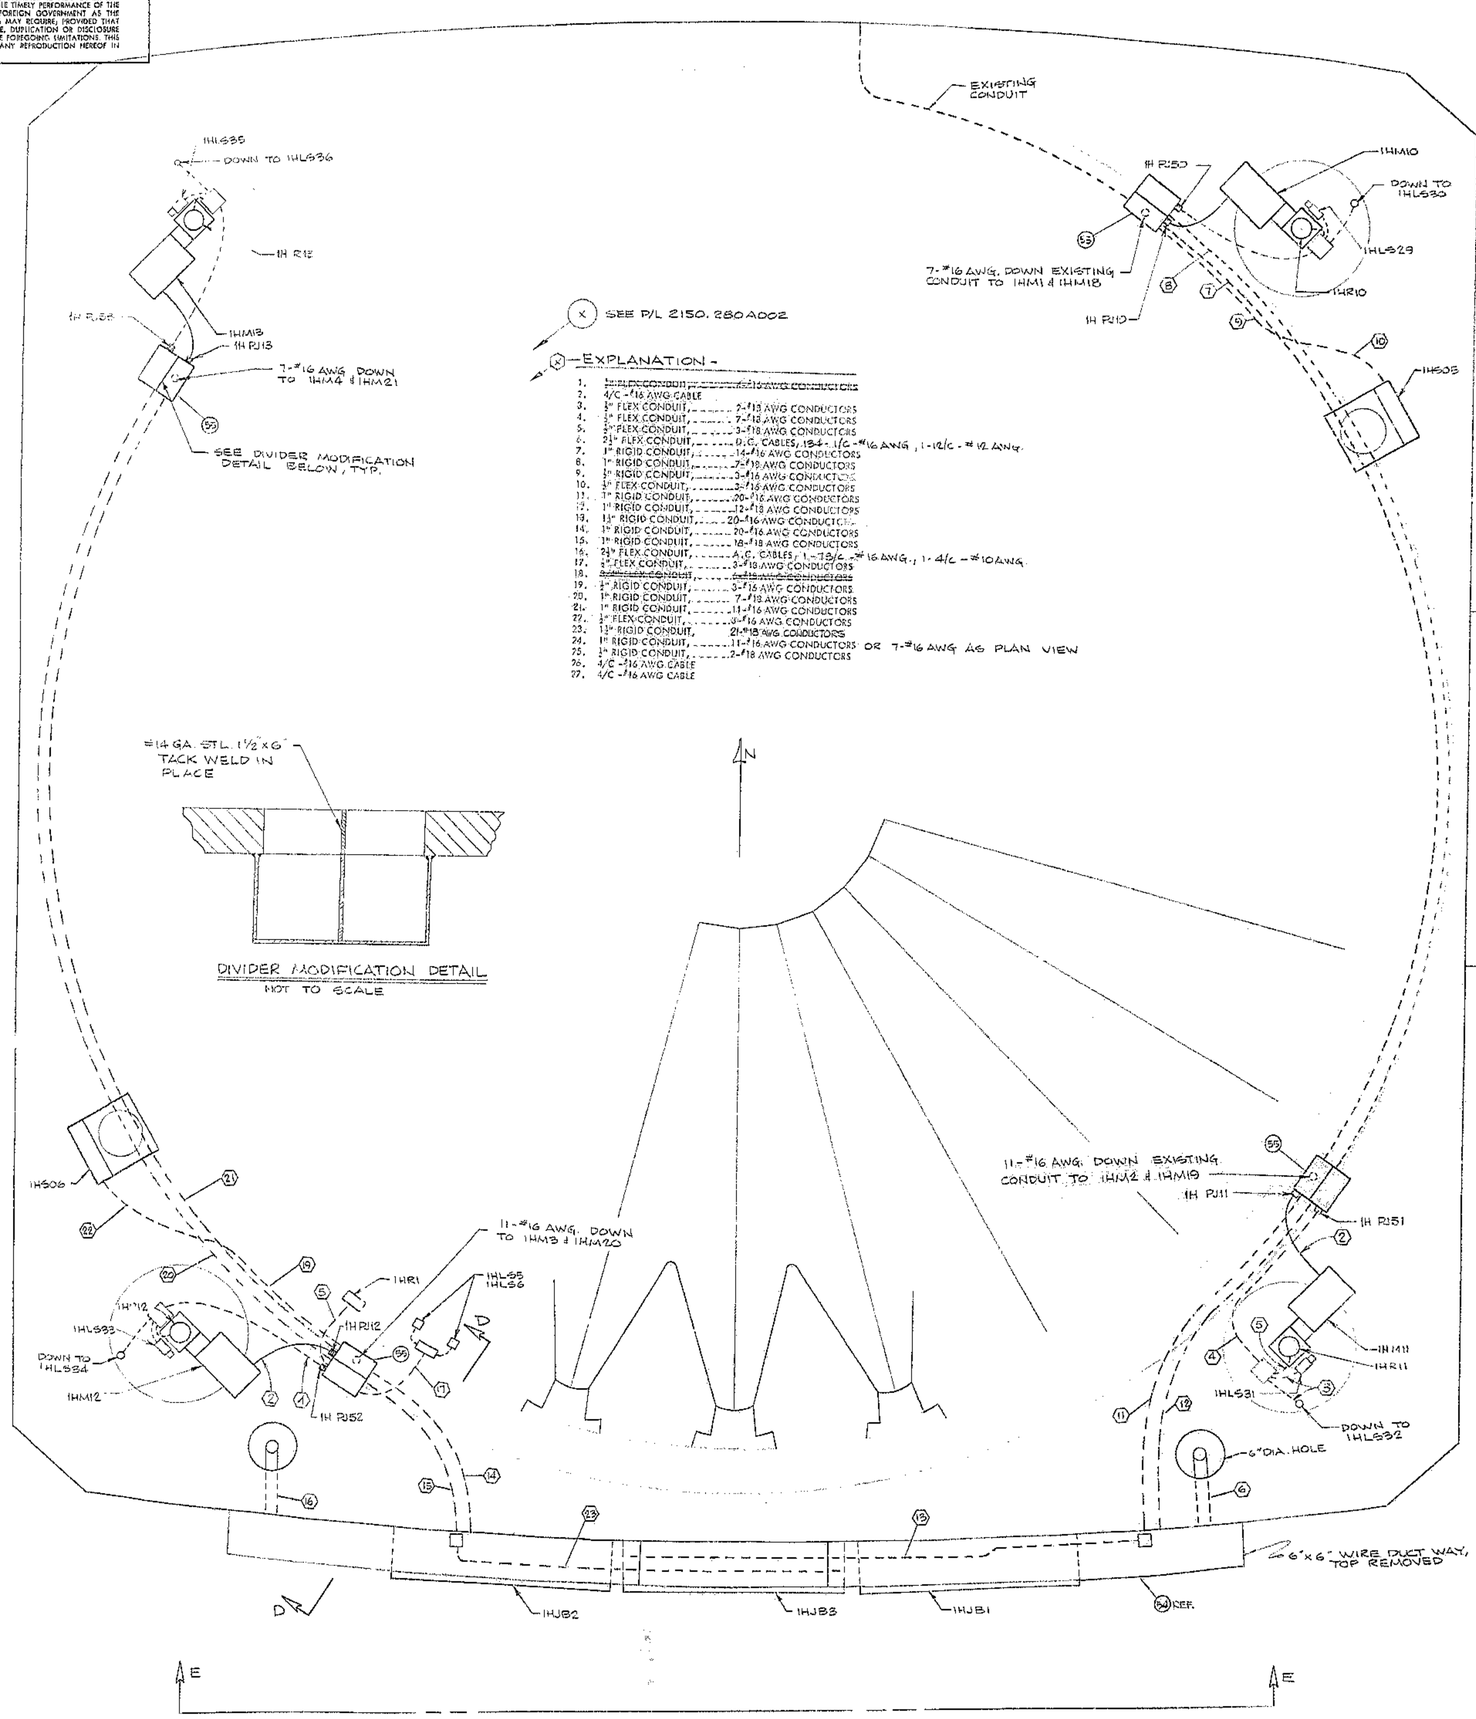

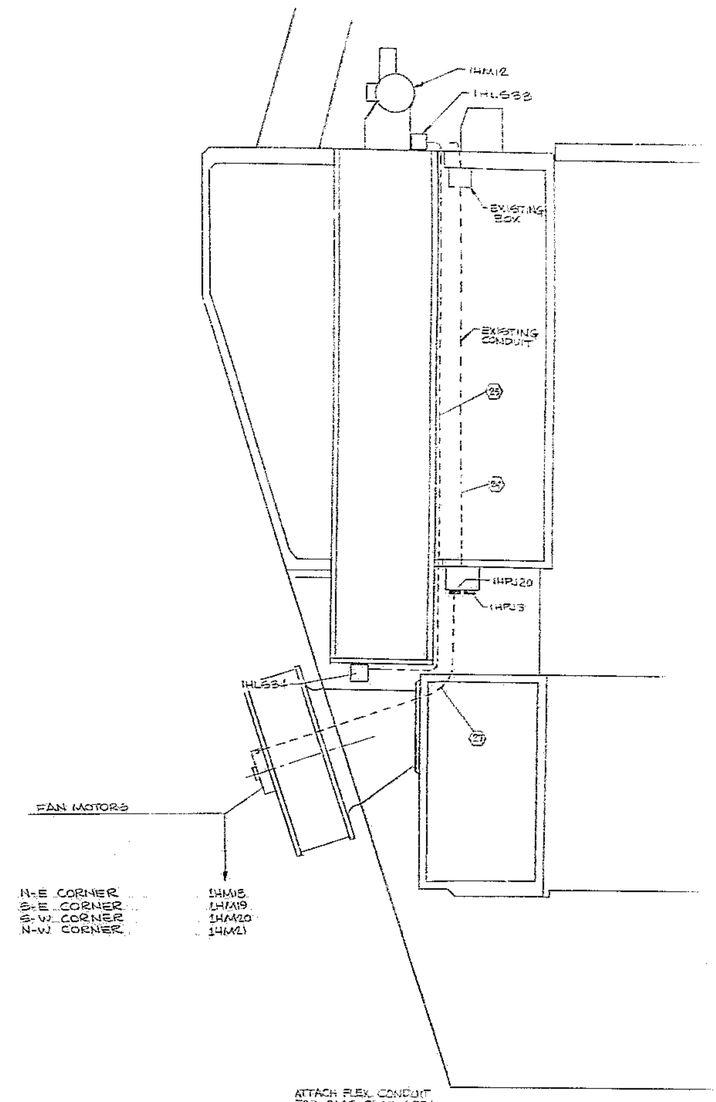

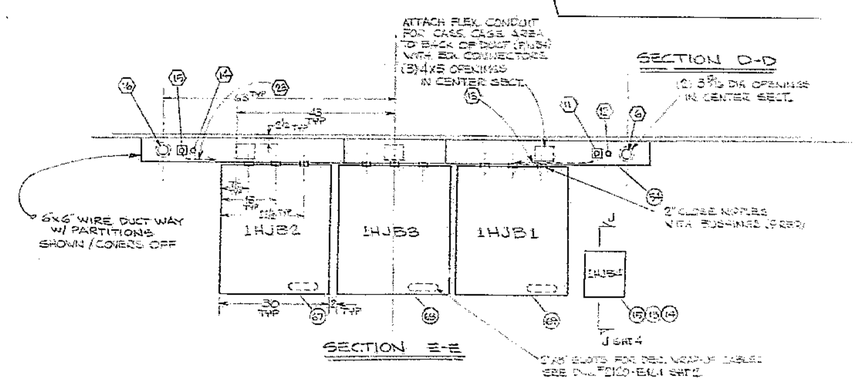

1174

FIND NO.	PART NO.	DESCRIPTION	QTY	MATERIAL	CODE IDENT

LIST OF MATERIAL (LM)

LIMITS ON MACHINED DIMENSIONS EXCEPT AS NOTED
ANGULAR ± 1°0'
LINEAR:
.X ± .1 .XXX ± .010
.XX ± .03 FRACTIONAL ± 1/32
BREAK ALL SHARP EDGES
MATERIAL

150" STELLAR TELESCOPE

DRAWN
CHECK
ENGR
TRACED - UPCS 12-2-78

WGN102844
APPROVED

western GEAR CORPORATION — HEAVY MACHINERY DIVISION, EVERETT, WASHINGTON

CENTER SECTION ASSEMBLY
ELECTRICAL CONDUIT & WIRE LAYOUT
(ROUTING & GENERAL LOCATION)

SIZE	CODE IDENT NO.		REV
E	16603	2150.280 E 002	P

SCALE NONE | WT ____ LB | SHEET 3 OF 4