BILL OF MATERIAL				
ITEM	QTY.	MATERIAL	DESCRIPTION	WEIGHT

FOR B/M SEE 2150.283 A 702

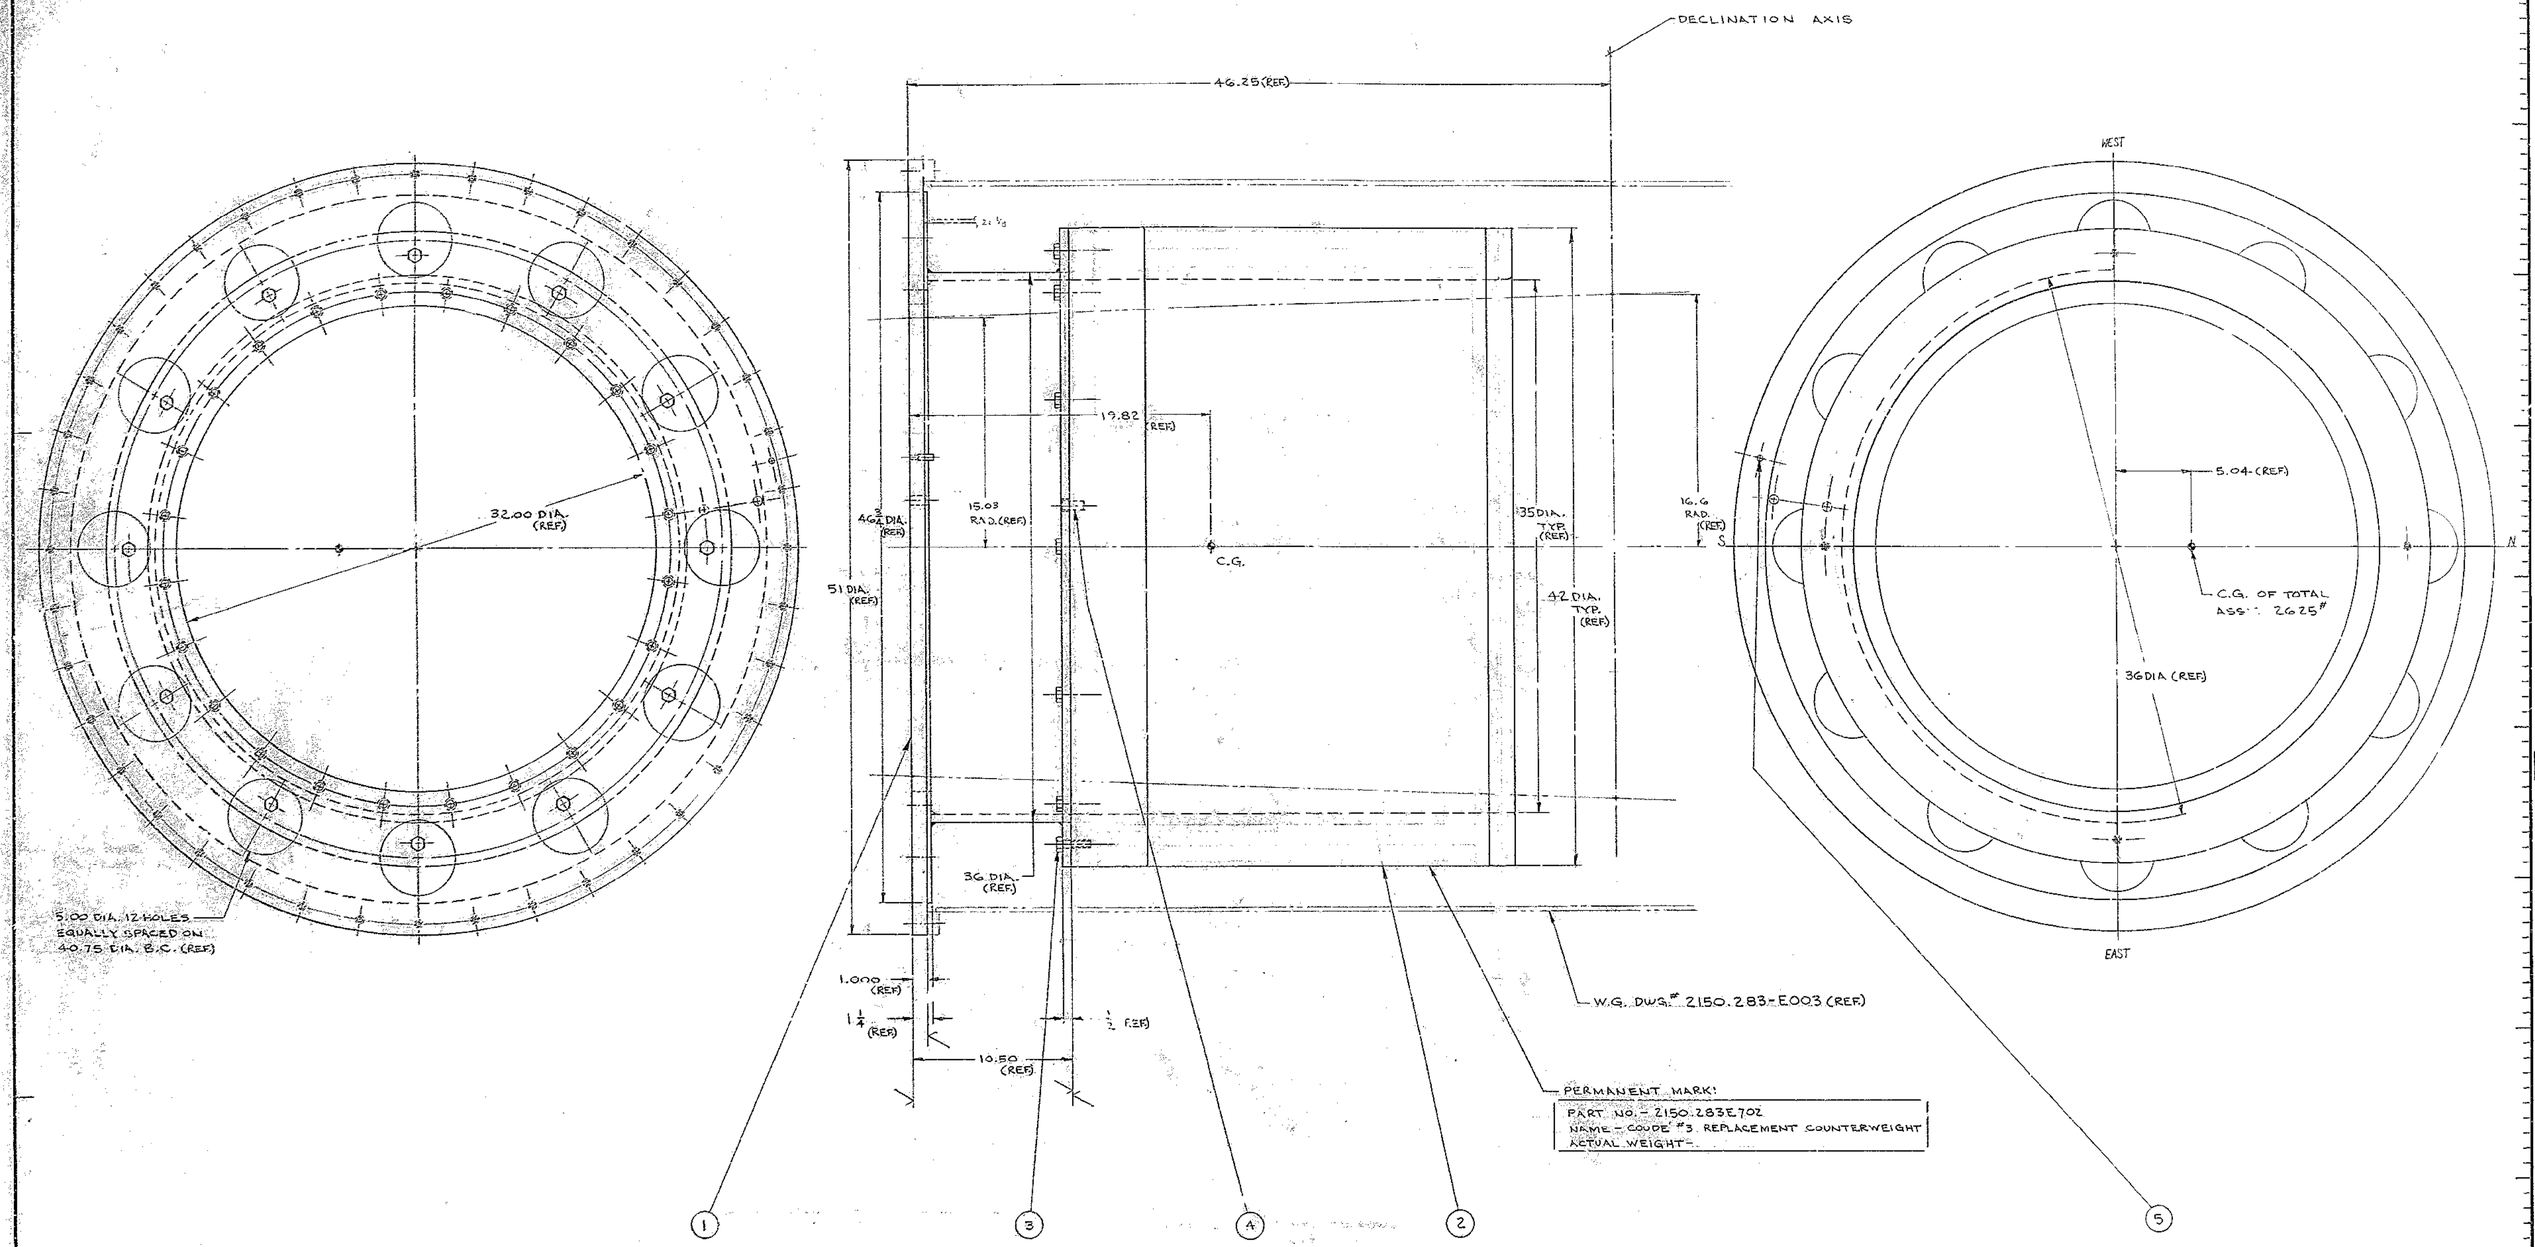

FOR ASSEMBLY SEE 2150.280-E002

LET.	REVISION	ECR	DATE	BY
A	AS BUILT	2288	7-17-79	CS

TOLERANCES UNLESS OTHERWISE NOTED
DECIMAL DIMENSIONS 00.00 ±.010 00.000 ±.005
FRACTIONAL DIMENSIONS UP TO 18" ± 1/64 18" TO 50" ± 1/32 50" & OVER ± 1/16
BREAK SHARP EDGES
ALL SURFACES 125 TO HAVE FINISH UNLESS OTHERWISE NOTED.

KITT PEAK NATIONAL OBSERVATORY
OPERATED BY THE ASSOCIATION OF UNIVERSITIES FOR RESEARCH IN ASTRONOMY, INC. UNDER CONTRACT WITH NATIONAL SCIENCE FOUNDATION

150 INCH STELLAR TELESCOPE — REF. FILE 1176

NAME: COUDE #3 REPLACEMENT COUNTERWEIGHT ASSY.-COUDE #3 AND CENTRAL BAFFLE ASSY.

SCALE 1/4 — PRINT ISSUED

DESIGNED BY	DATE	APPROVED BY	DATE
[illegible]	2-15-79	[illegible]	1/10/79
DRAWN BY	DATE	APPROVED BY	DATE
[illegible]	2-15-79		
CHECKED BY	DATE	APPROVED BY	DATE
[illegible]	2-15-76		

DRAWING NUMBER 2150·283-E702 — REV. A